




2400 EMPIRE CENTRAL
AS BUILTS

SUITE A - 5439 SF
SUITE B - 515 SF
SUITE C - 396 SF
SUITE D - 1064 SF
SUITE E - 1666 SF
SUITE F - 449 SF
COMMON - 1577 SF
TOTAL - 11,106 SF

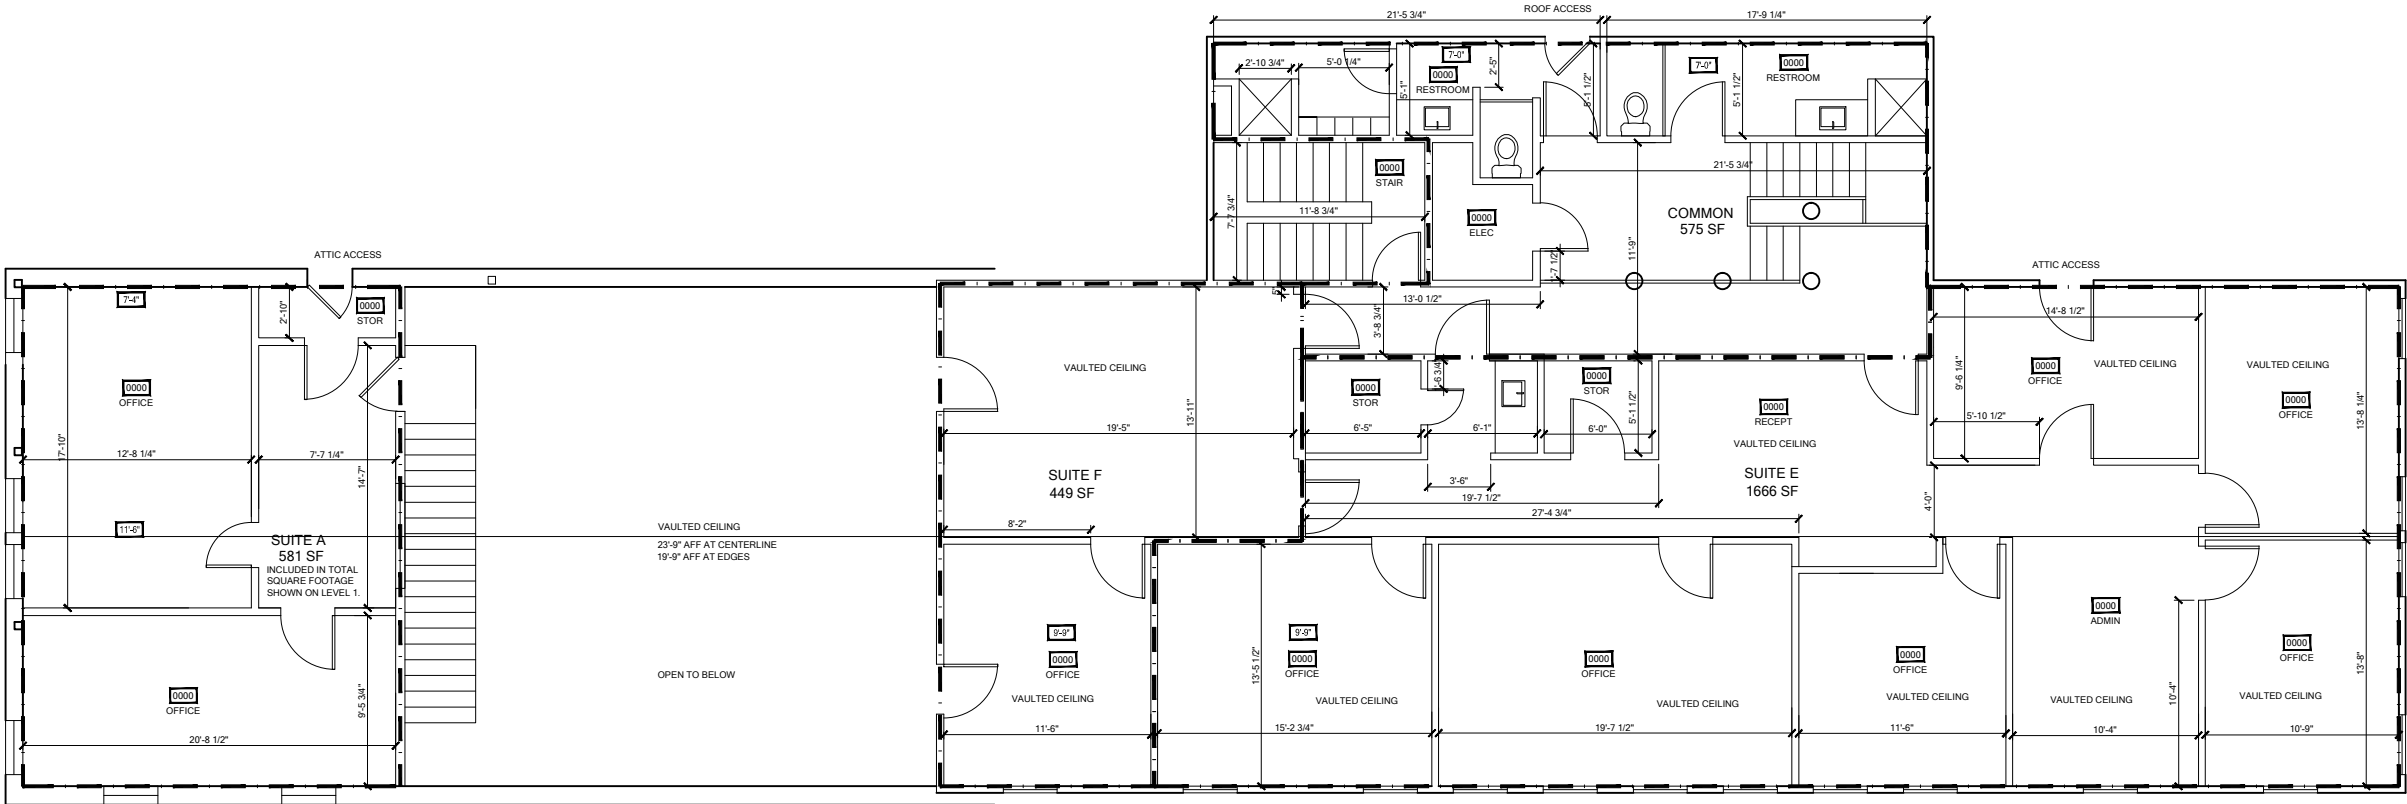